

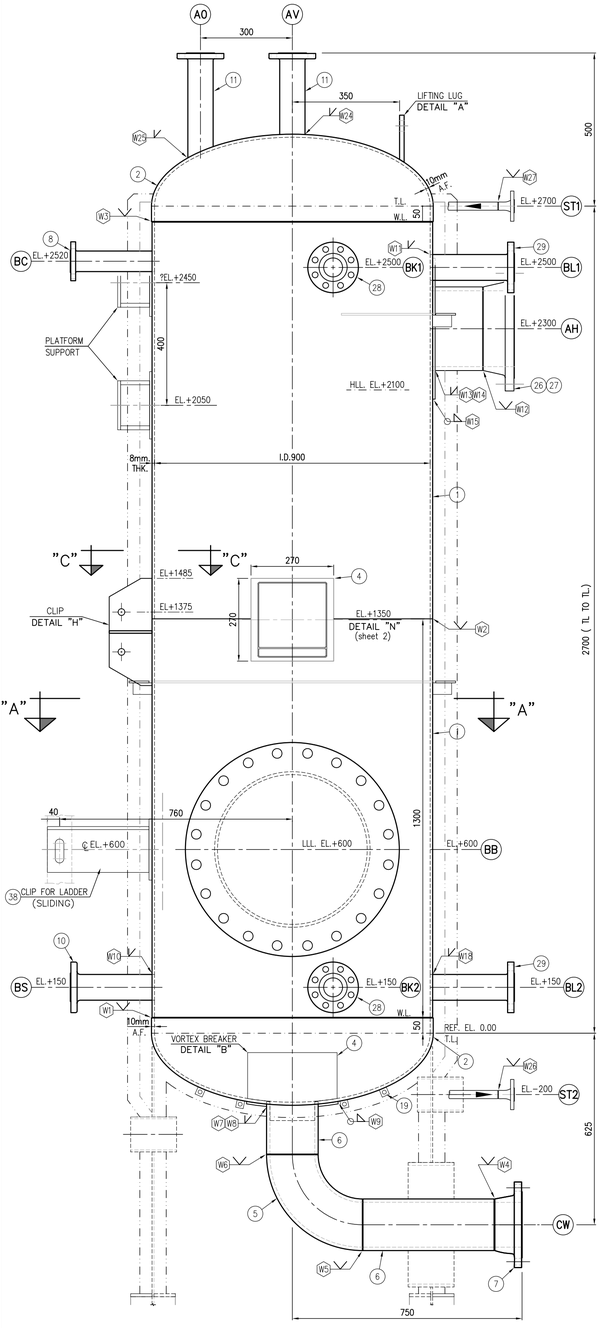


VESSEL ELEVATION

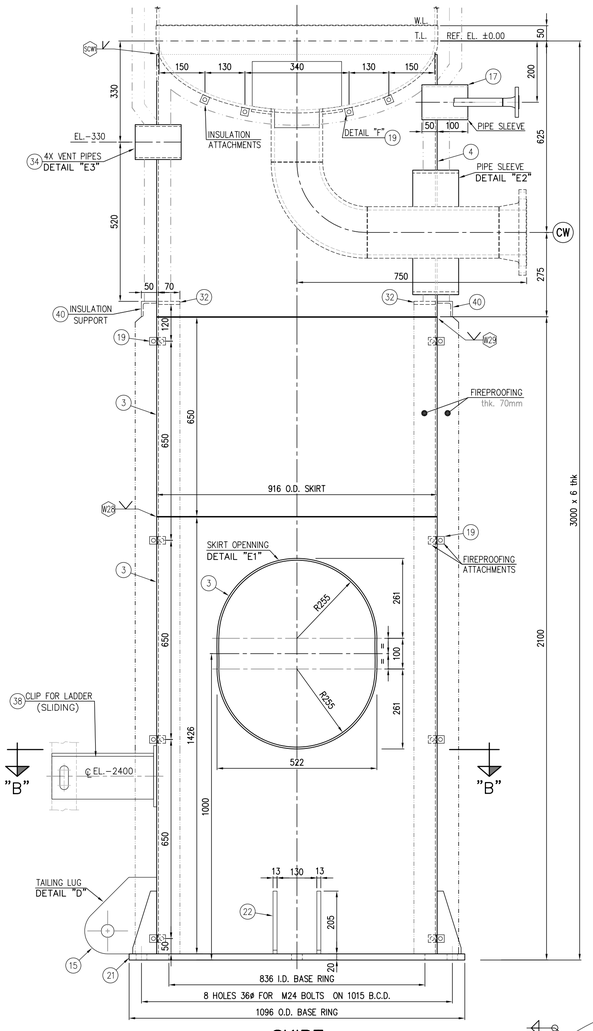


SKIRT ELEVATION

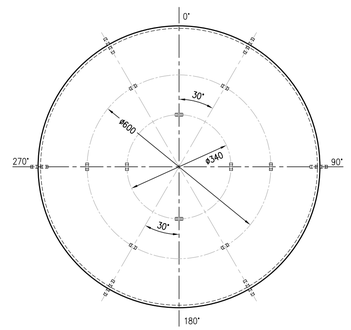


DETAIL "F"

POSITIONING OF FIREPROOFING ATTACHMENTS ON VESSEL BOTTOM HEAD & SKIRT

SCALE 1 : 10

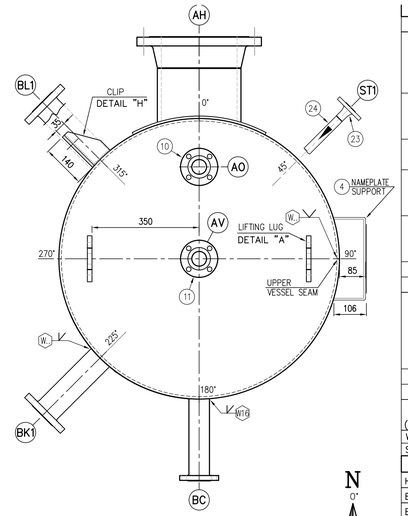


TOP VIEW

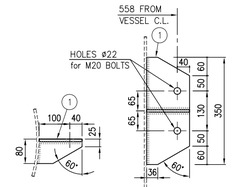


DETAIL "H"

PIPE CLIP (1 pc)


SCALE 1 : 10

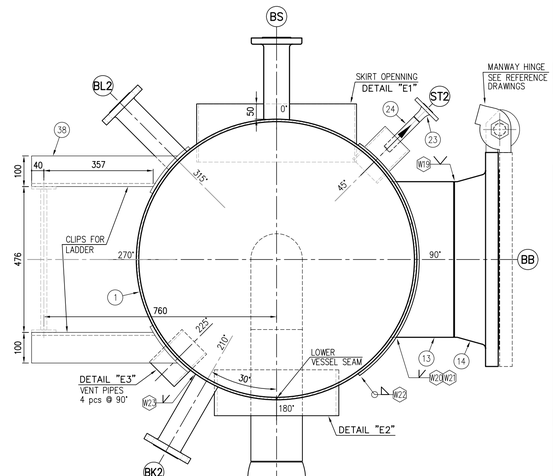

SECTION "A-A"

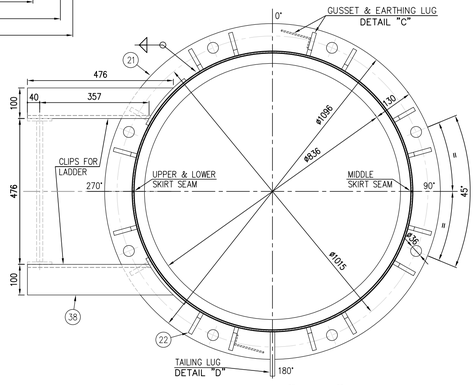


SECTION "B-B"

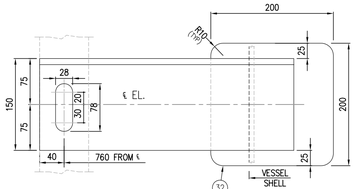

DETAIL "G"

CLIP FOR LADDER

SCALE 1 : 5

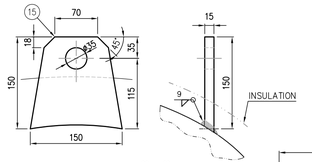


DETAIL "A"

LIFTING LUG

(2 pcs)

SCALE 1 : 5

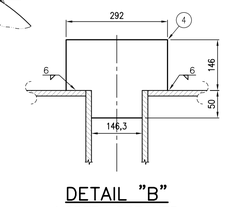


DETAIL "B"

VORTEX BREAKER

(1 pc)

SCALE N.T.S.

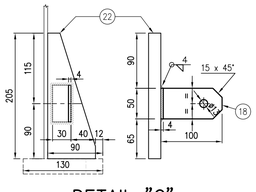


DETAIL "C"

GUSSET & EARTHING LUG

(GUSSET: 16 pcs, EARTHING LUG: 2 pcs)

SCALE 1 : 5

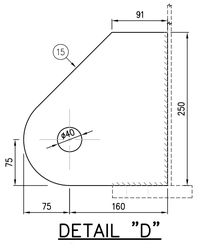


DETAIL "D"

TAILING LUG

(1 pc)

SCALE 1 : 5

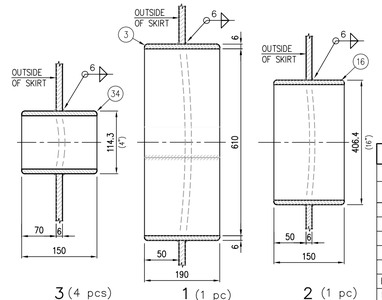

DETAIL "E"

SKIRT OPENING DETAILS

SCALE N.T.S.

DESIGN DATA

DESIGN CODE /ASME (U) STAMP				ASME SEC. VIII DIV.1 2007 ED./NO
DESIGN CONDITIONS AT TOP	PRESSURE (INT./EXT.)		Kg/cm² (g)	4.5 / HALF VACUUM
	TEMPERATURE FOR INT./EXT. PRESSURE		°C	240/240
	PRESSURE DROP		Kg/cm² (g)	–
	MIN. DESIGN METAL TEMP.		°C	-1
OPERATING CONDITIONS	PRESSURE (TOP/BOTTOM)		Kg/cm² (g)	2.1
	TEMPERATURE (TOP/BOTTOM)		°C	55
	LOW TEMPERATURE/PRESSURE		°C/Kg/cm² (g)	–
STEAM-OUT CONDITION	PRESSURE		Kg/cm² (a)	–
	TEMPERATURE		°C	–
FLUID	NATURE		– –	WATER
	SPECIFIC GRAVITY		–	0.988
	MAXIMUM LIQUID LEVEL		mm	2100
SPECIAL SERVICES	H2 SERVICE		–	NO
	WET H2S SERVICE		– –	NO
	AMINE SERVICE		– –	NO
POSTWELD HEAT TREATMENT				NO
RADIOGRAPHY	JOINT EFFICIENCY			SPOT | 0.85
CORROSION ALLOWANCE	SHELL AND HEADS (INT./EXT.)		mm	3
	SKIRT		mm	1.5
	ANCHOR BOLTS		mm	0.0
	INTERNALS	REMOVABLE	mm	1.5 ON EACH FACE
		WELDED	mm	3 ON EACH FACE
INSULATION THICKNESS / TYPE			mm	40 (HC)
FIREPROOFING THK.			mm	70/70
HYDROTEST PRESSURE (AT TOP) (NOTE 7)	INITIAL	HORIZONTAL	Kg/cm² (g)	6.70
		VERTICAL	Kg/cm² (g)	6.5
WIND CONDITIONS CODE / SPEED				AS PER ERUP-SPC-CI-004
SEISMIC CONDITIONS CODE / FACTORS				

SPECIFICATIONS

HELLENIC PETROLEUM S.A.	U O P	
ERUP-SPC-CI-004	3-11-5	
ERUP-SPC-ME-001	3-122-3	
ERUP-SPC-ME-012, 014		

PAINTING SYSTEM

CARBON STEEL SURFACES	AS PER ERUP-SPC-ME-012
STAINLESS STEEL SURFACES	–

MOMENTS AND FORCES AT BASE PLATE			ESTIMATED WEIGHT AND CAPACITY		
EARTH. BENDING MOMENT	8200	Kgm	ERECTION WEIGHT	2814	Kg.
WIND BENDING MOMENT	5300	Kgm	SHUT-DOWN WEIGHT	2814	Kg.
EARTHQUAKE SHEAR	1900	Kg.	OPERATING WEIGHT	3888	Kg.
WIND SHEAR	1100	Kg.	HYDROSTEST WEIGHT	4722	Kg.
			CAPACITY	1,96	m³

REFERENCE DRAWINGS

DRAWING No :	TITLE
BD0300A-00-11-001	VESSEL STANDARD
7660-MPS rev.1	MATERIAL PURCHASE SPECIFICATION
7660-CL-16	ASME VIII CALCULATION 34-11-V-056
7660-PZ-51_sh.2	CONSTRUCTION DRAWING FOR HORIZONTAL MANWAYS
01990-SPC-ME-012	DOSSIER OF VESSEL PROJECT STANDARDS

GENERAL NOTES

1. DIMENSIONS ARE IN MILIMETERS (mm) UNLESS OTHERWISE SPECIFIED.
2. FOR VERTICAL NOZZLES, BOLT HOLES SHALL STRADDLE THE N-S AND E-W AXIS. FOR HORIZONTAL NOZZLES, BOLT HOLES SHALL STRADDLE THE VERTICAL AND HORIZONTAL AXIS.
3. EACH REINFORCING PAD SHALL BE PNEUMATICALLY TESTED AT A PRESSURE OF 0.5 BAR(g) USING WATER WITH SOAP TO DETECT POSSIBLE LEAKAGES.
4. FITTINGS SHALL BE OF THE SAME SIZE AND THICKNESS AS THE ATTACHED PIPES.
5. UNLESS PROJECTIONS ARE SPECIFIED, NOZZLES, MANWAYS AND HANDHOLES SHALL BE CUT OFF FLUSH WITH THE INSIDE OF THE SHELL OR HEAD OF PRESSURE VESSEL.
6. DELETED
7. VERTICAL SHOP FABRICATED VESSELS IF HYDROTESTED IN THE HORIZONTAL POSITION, THE HYDROTEST PRESSURE WILL BE INCREASED TO CONSIDER THE STATIC HEAD PRESENT WHEN THE VESSEL IS IN VERTICAL POSITION.
8. DELETED
9. MPSC REFERENCE ON THE BOM REMARKS IS INCORPORATED IN THE MATERIAL PURCHASE SPECIFICATION DOC. No : 7660-MPS rev.1
10. FOR STEAM TRACING, INSULATION AND PLATFORM SUPPORTS, SEE SHEET 2.
11. PED CLASSIFICATION.
    FLUID: GAS, GROUP: 2, CATEGORY: IV

LEGEND

(XX) : NOZZLE MARKS

XX : MATERIAL LIST ITEMS

W. : WELD NUMBER

X : REVISION INDEX

WELDING DETAILS

BASIC SYMBOLS	SINGLE	DOUBLE	NOTES
FILLET WELD PLANE TYPE			UNLESS STATED OTHERWISE IN SHOP DETAILED DWGS, ALL FILLET WELDS MUST BE CONTINUOUS AND SHALL HAVE THICKNESS EQUAL TO 7/10 OF MINIMUM THICKNESS OF THE PLATES TO BE WELDED
			INTERMITTENT STAGGERED FILLET WELDS
"V" GROOVE PENETRATION WELD			SINGLE VEE GROOVE 6mm ≤ T ≤ 20mm DOUBLE VEE GROOVE ON BOTH SIDES SYMMETRICAL ABOUT REF. LINES T ≥ 20mm
SINGLE BEVEL GROOVE PENETRATION WELD			SINGLE BEVEL GROOVE 6mm ≤ T ≤ 20mm DOUBLE BEVEL GROOVE FINISH HALF CONVEX AND HALF FLUSH T ≥ 20mm

REV.	DRAWN	DATE	DESCRIPTION	CHECK.	APPR.	PMgnt.
6	A.V.	25.11.10	AS BUILT	E.V.	V.G.	G.V.
5	A.V.	20.06.10	ISSUED FOR APPROVAL/CONSTRUCTION	E.V.	V.G.	G.V.
4	A.V.	23.03.10	ISSUED FOR APPROVAL/CONSTRUCTION	E.V.	V.G.	G.V.
3	A.V.	06.11.09	ISSUED FOR APPROVAL/CONSTRUCTION	E.V.	V.G.	G.V.
2	S.K.	06.08.09	ISSUED FOR APPROVAL	E.V.	V.G.	G.V.
1	A.V.	28.05.09	ISSUED FOR APPROVAL	E.V.	V.G.	G.V.

DOCUMENT INDEX

PROJECT: ELEFSIS REFINERY UPGRADE PROJECT
DESCRIPTION: VESSEL: 34-11-V-056 MTO
PRODUCT No: 01.02.A7660.018 *PRODUCT Order:*

BILL OF MATERIAL

ITEM	ERP QTY		ERP CODE	ERP DESCRIPTION	REMARKS
1	560,0	Kgr	03.04.03.0729	PLATE 8mm A 516 Gr.70	MPSC 01
2	2	pcs	03.00.00.0701	Ellipsoi head 10mm SA 516 Gr. 70N FOR 01990-34-11-V-056	MPSC 01: MIN. THICK. AFTER FORMING 8 mm
3	375	Kgr	03.04.03.0741	PLATE 6mm A516 Gr.60	MPSC 12
4	170	Kgr	03.04.03.0749	PLATE 6mm A 516 Gr.70	MPSC 01
5	1	pc	03.04.01.1695	ELBOW 90 BE LR 6in SCH.XS A234 Gr.WPB EU	MPSC 10
6	1	m	03.04.01.0277	PIPE SMLS BE 6in SCH.XS A106 Gr.B EU	MPSC 03
7	1	pc	03.04.01.1122	FLANGE WN RF 6in 150# SCH.XS A105N EU	MPSC 06
8	1	pc	03.04.01.4698	FLANGE LONG WN RF 1.1/2in X 250mm 150# A105 EU	MPSC 06
9	1	pcs	03.04.01.4717	FLANGE LONG WN RF 2in X 280mm 300# A105 EU	MPSC 06
10	1	pc	03.04.01.4722	FLANGE LONG WN RF 2in X 320mm 150# A105 EU	MPSC 06
11	2	pcs	03.04.01.3714	FLANGE LONG WN RF 2in X 410mm 150# A105 EU	MPSC 06
12				DELETED	
13	0,25	m	03.04.01.1244	PIPE SMLS BE 20in SCH.STD A106 Gr.B EU	MPSC 03
14	1	pc	03.04.01.3032	FLANGE WN RF 20in 150# SCH.STD A105N EU	MPSC 06
15	40	Kgr	03.04.03.0432	PLATE 15mm A516 Gr.70	MPSC 12
16	0,15	mt	03.04.01.0298	PIPE SMLS BE 16in SCH.STD A106 Gr.B EU	MPSC 03
17	0,2	mt	03.04.01.0135	PIPE SMLS BE 4in SCH.STD A106 Gr.B EU	MPSC 03
18	1	Kgr	03.04.03.0003	PLATE 4mm SS304	-
19	58	pcs	03.04.03.0221	SQUARE NUT M13 SA 516 Gr.70	-
20				DELETED	-
21	40	Kgr	03.04.03.0789	PLATE 20mm A516 Gr.60	MPSC 12
22	40	Kgr	03.04.03.0639	PLATE 13mm A516 Gr.60	MPSC 12
23	4	pcs	03.04.01.2294	FLANGE WN RF 3/4in 150# SCH.160 A105N EU	
24	43,0	m	03.04.01.0437	PIPE SMLS BE 3/4in SCH.160 A106 Gr.B EU	
25	10	Kgr	03.04.03.0211	ROUND 20mm ST 37.2/S235JR	-
26	0,2	m	03.04.01.0134	PIPE SMLS BE 10in SCH.XS A106 Gr.B EU	MPSC 03
27	1	pc	03.04.01.2986	FLANGE WN RF 10in 150# SCH.XS A105N EU	MPSC 06
28	1	pc	03.04.01.4724	FLANGE LONG WN RF 2in X 320mm 300# A105 EU	
29	2	pcs	03.04.01.4716	FLANGE LONG WN RF 2in X 280mm 150# A105 EU	
30	25	Kgr	03.04.03.0034	PLATE 6mm ST 37.2/S235JR	
31				DELETED	
32	15	Kgr	03.04.03.0221	PLATE 10mm A516 Gr.70	MPSC-01
33	2	pcs	03.04.01.0441	ELBOW 90 BE LR 3/4in SCH.160 A234 Gr.WPB EU	MPSC 10
34	0,6	m	03.04.01.0113	PIPE SMLS BE 4in SCH.XS A106 Gr.B EU	MPSC 03
35	21	Kgr	03.04.03.0560	BEAM IPB (HEB) 160 ST 37.2/S235JR	
36	27	Kgr	03.04.03.0153	CHANNEL UPN 180 ST 37.2/S235JR	
37	25	Kgr	03.04.03.0091	PLATE 15mm ST 37.2/S235JR	MPSC 12
38	38	Kgr	03.04.03.0589	ANGLE UNEQUAL 150X100X10 ST 44.2/S275JR	
39	35	Kgr	03.04.03.0163	PLATE 10mm ST 37.2/S235JR	MPSC 12
40	15	Kgr	03.04.03.0558	ANGLE EQUAL 50X6 ST 37.2/S235JR	

NOZZLE SCHEDULE

MARK N°	QTY	NOM. DIA	PROJ. "L"	DESCRIPTION	FLANGES CLASS	FLANGES TYPE	FLANGES FACE	NECK SCH./THK	REINFORC. WIDTH O.D.	REINFORC. THK	FORCES (KgF) FA	FL	FC	MOMENTS (KgFxm) MA	ML	MT
AH	1	10"	725	RELIEF	CL150	W.N.	R.F.	SCH.XS	460	8	953,4	1059,4	900,4	750	562,5	937,5
AO	1	2"	see DWG.	BLANKETING GAS	CL150	L.W.N.	R.F.	–	–	–	149,8	166,4	141,4	30	22,5	37,5
AV	1	2"	see DWG.	VENT	CL150	L.W.N.	R.F.	–	–	–	149,8	166,4	141,4	30	22,5	37,5
BB	1	20"	725	MANWAY WITH B.F & HINGE	CL150	W.N.	R.F.	SCH.STD	900	8	–	–	–	–	–	–
BC	1	1½"	725	SPILLBACK	CL150	L.W.N.	R.F.	–	–	–	107,5	119,5	101,6	16,8	12,6	21
BK1-2	2	2"	725	DP CELL	CL300	L.W.N.	R.F.	–	–	–	–	–	–	–	–	–
BL1-2	2	2"	725	STANDPIPE	CL150	L.W.N.	R.F.	–	–	–	–	–	–	–	–	–
BS	1	2"	725	STEAMOUT	CL150	L.W.N.	R.F.	–	–	–	149,8	166,4	141,4	30	22,5	37,5
CW	1	6"	see DWG.	INLET /OUTLET	CL150	W.N.	R.F.	SCH.80	300	8	529,8	588,7	500,4	270	202,5	337,5
ST1	1	3/4"	725	STEAM TRACER INLET	CL150	W.N.	R.F.	SCH.160	–	–	–	–	–	–	–	–
ST2	1	3/4"	725	STEAM TRACER OUTLET	CL150	W.N.	R.F.	SCH.160	–	–	–	–	–	–	–	–

PURCHASE ORDENER No.	EQUIPMENTS / TAGS No.	TR PROJECT No.	
0199003150	34-V-056	1990	


REVIEW RESPONSE BY PURCHASER :

DATE :


VENDOR IDENTIFICATION : METRON S.A.

DOCUMENT TITLE : CONSTRUCTION DRAWING VESSEL: WASH WATER TANK


VENDOR DOCUMENT No. :	REV :	CODE :
7660-PZ-16 sheet 1 / 2	6	PLG-0003
TR DOCUMENT No. :	REV :	SCALE :
		1 : 10

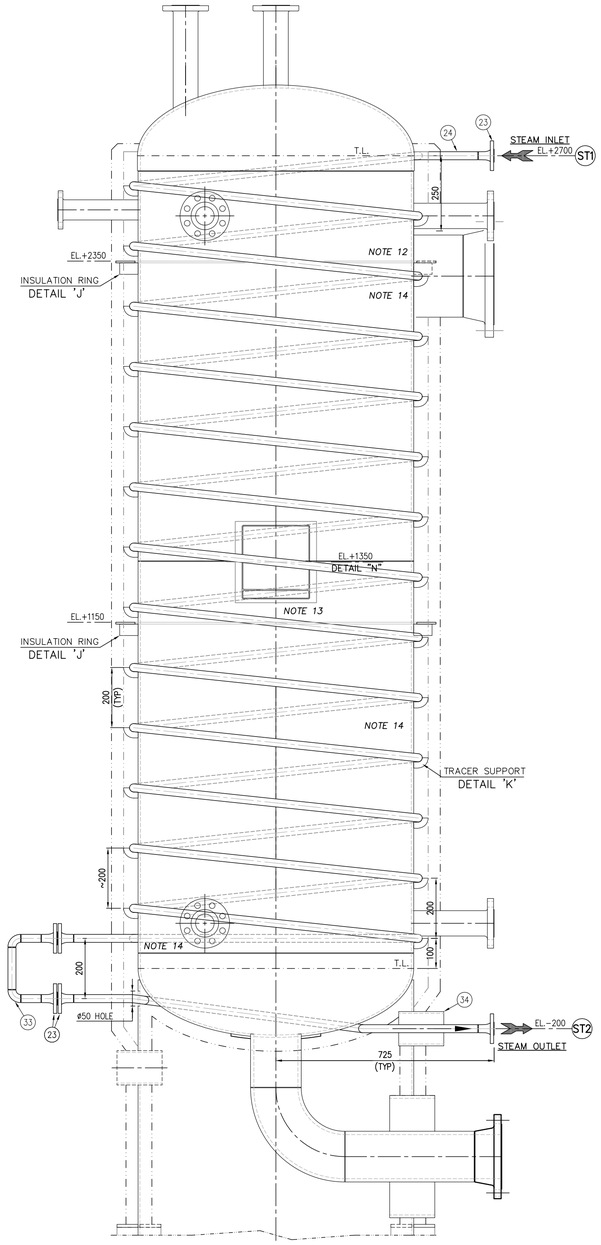


DETAIL "I"
INSULATION RINGS
STEAM TRACING
INDICATIVE

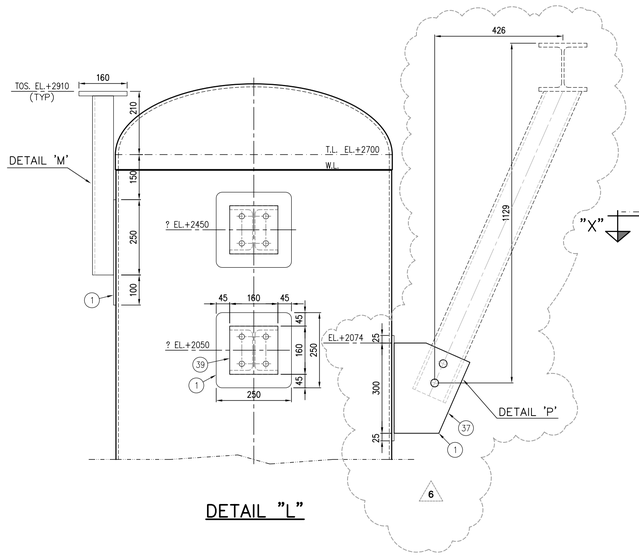


DETAIL "L"

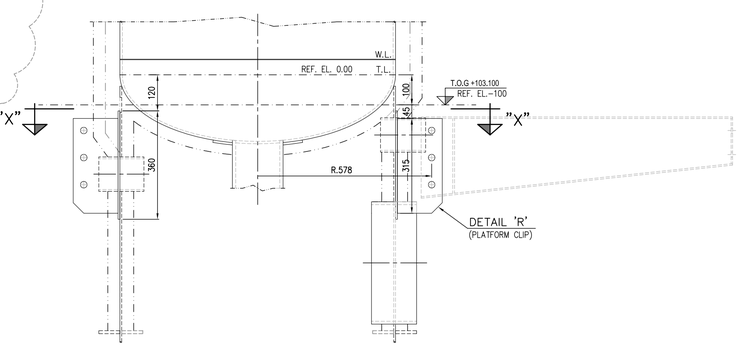


DETAIL "Q"
BOTTOM PLATFORM CLIPS
ELEVATION

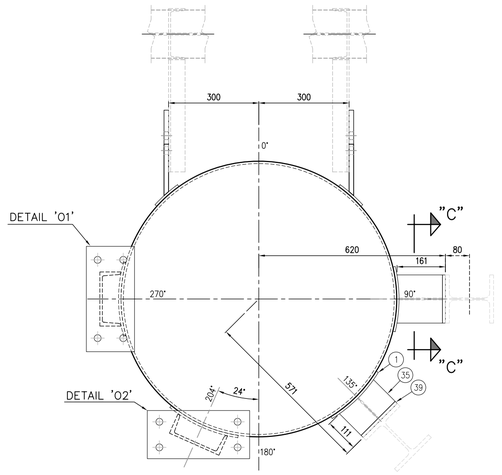

DETAIL "L"
TOP PLATFORM SUPPORTS
TOP VIEW

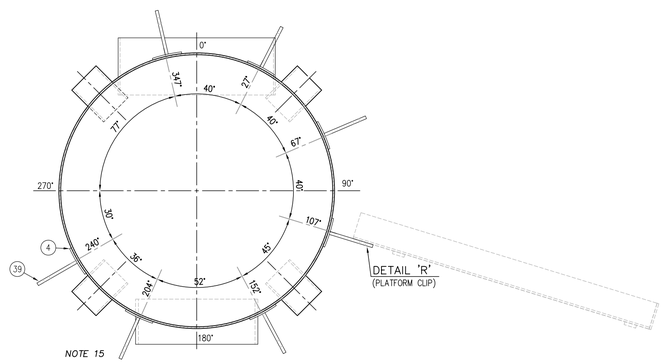


DETAIL "Q"
BOTTOM PLATFORM CLIPS
SECTION 'X–X'

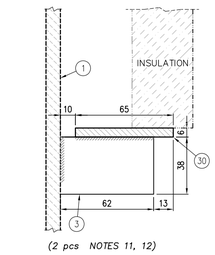


(2 pcs NOTES 11, 12)

DETAIL "J"
INSULATION SUPPORT RING
SCALE 1 : 2

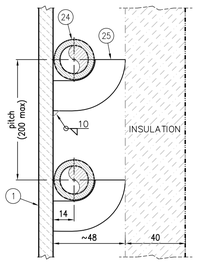


DETAIL "K"
TRACER SUPPORT
SCALE 1 : 2

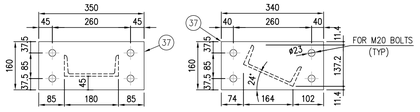


DETAIL "O1"
DETAIL "O2"


DETAIL "O"
SCALE 1 : 10

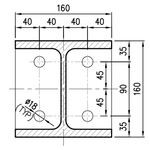


SECTION "C–C"
SCALE 1 : 5

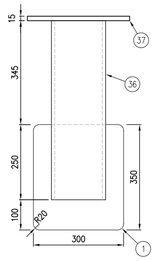


DETAIL "M"
SCALE 1 : 10

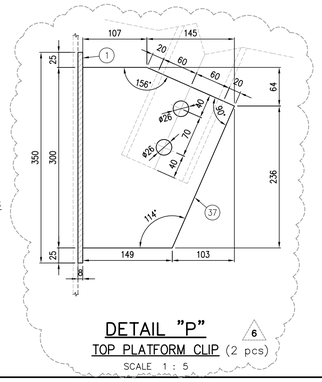


DETAIL "P"
TOP PLATFORM CLIP (2 pcs)
SCALE 1 : 5

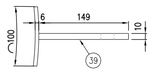

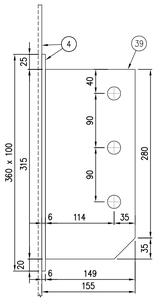

DETAIL "R"
BOTTOM PLATFORM CLIP (6 pcs)
SCALE 1 : 5

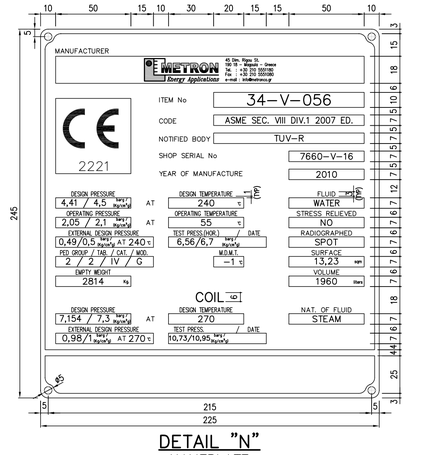

DETAIL "N"
NAMEPLATE
SCALE 1 : 2

DOCUMENT INDEX

PROJECT: ELEFSIS REFINERY UPGRADE PROJECT
DESCRIPTION: VESSEL: 34-11-V-056 MTO
PRODUCT No: 01.02.A7660.018 *PRODUCT Order:*

BILL OF MATERIAL


ITEM	ERP QTY		ERP CODE	ERP DESCRIPTION	REMARKS
1	560,0	Kgr	03.04.03.0729	PLATE 8mm A 516 Gr.70	MPSC 01
2	2	pcs	03.00.00.0701	Elliptical head 10mm SA 516 Gr. 70N FOR 01990-34-11-V-056	MPSC 01. MIN. THICK. AFTER FORMING 8 mm
3	375	Kgr	03.04.03.0741	PLATE 6mm A516 Gr.60	MPSC 12
4	170	Kgr	03.04.03.0749	PLATE 6mm A 516 Gr.70	MPSC 01
5	1	pc	03.04.01.1695	ELBOW 90 BE LR 6in SCH.XS A234 Gr.WPB EU	MPSC 10
6	1	m	03.04.01.0277	PIPE SMLS BE 6in SCH.XS A106 Gr.B EU	MPSC 03
7	1	pc	03.04.01.1122	FLANGE WN RF 6in 150# SCH.XS A105N EU	MPSC 06
8	1	pc	03.04.01.4698	FLANGE LONG WN RF 1.1/2in X 290mm 150# A105 EU	MPSC 06
9	1	pcs	03.04.01.4717	FLANGE LONG WN RF 2in X 280mm 300# A105 EU	MPSC 06
10	1	pc	03.04.01.4722	FLANGE LONG WN RF 2in X 320mm 150# A105 EU	MPSC 06
11	2	pcs	03.04.01.3714	FLANGE LONG WN RF 2in X 410mm 150# A105 EU	MPSC 06
12				DELETED	
13	0,25	m	03.04.01.1244	PIPE SMLS BE 20in SCH.STD A106 Gr.B EU	MPSC 03
14	1	pc	03.04.01.3032	FLANGE WN RF 20in 150# SCH.STD A105N EU	MPSC 06
15	40	Kgr	03.04.03.0432	PLATE 15mm A516 Gr.70	MPSC 12
16	0,15	mt	03.04.01.0298	PIPE SMLS BE 16in SCH.STD A106 Gr.B EU	MPSC 03
17	0,2	mt	03.04.01.0135	PIPE SMLS BE 4in SCH.STD A106 Gr.B EU	MPSC 03
18	1	Kgr	03.04.03.0003	PLATE 4mm SS304	-
19	58	pcs	03.04.03.0221	SQUARE NUT M13 SA 516 Gr.70	-
20				DELETED	-
21	40	Kgr	03.04.03.0789	PLATE 20mm A516 Gr.60	MPSC 12
22	40	Kgr	03.04.03.0639	PLATE 13mm A516 Gr.60	MPSC 12
23	4	pcs	03.04.01.2294	FLANGE WN RF 3/4in 150# SCH.160 A105N EU	
24	43,0	m	03.04.01.0437	PIPE SMLS BE 3/4in SCH.160 A106 Gr.B EU	
25	10	Kgr	03.04.03.0211	ROUND 20mm ST 37.2/S235JR	-
26	0,2	m	03.04.01.0134	PIPE SMLS BE 10in SCH.XS A106 Gr.B EU	MPSC 03
27	1	pc	03.04.01.2986	FLANGE WN RF 10in 150# SCH.XS A105N EU	MPSC 06
28	1	pc	03.04.01.4724	FLANGE LONG WN RF 2in X 320mm 300# A105 EU	
29	2	pcs	03.04.01.4716	FLANGE LONG WN RF 2in X 280mm 150# A105 EU	
30	25	Kgr	03.04.03.0034	PLATE 6mm ST 37.2/S235JR	
31				DELETED	
32	15	Kgr	03.04.03.0221	PLATE 10mm A516 Gr.70	MPSC-01
33	2	pcs	03.04.01.0441	ELBOW 90 BE LR 3/4in SCH.160 A234 Gr.WPB EU	MPSC 10
34	0,6	m	03.04.01.0113	PIPE SMLS BE 4in SCH.XS A106 Gr.B EU	MPSC 03
35	21	Kgr	03.04.03.0560	BEAM IPB (HEB) 160 ST 37.2/S235JR	
36	27	Kgr	03.04.03.0153	CHANNEL UPN 180 ST 37.2/S235JR	
37	25	Kgr	03.04.03.0091	PLATE 15mm ST 37.2/S235JR	MPSC 12
38	3	Kgr	03.04.03.0589	ANGLE UNEQUAL 150X100X10 ST 44.2/S275JR	
39	35	Kgr	03.04.03.0163	PLATE 10mm ST 37.2/S235JR	MPSC 12
40	15	Kgr	03.04.03.0558	ANGLE EQUAL 50X6 ST 37.2/S235JR	

GENERAL NOTES



11. 6 RING SUPPORTING PLATES SHALL BE EQUALLY SPACED, STARTING FROM 45°, WITH POSSIBLE MICRO-ADJUSTMENT AT FIELD.
12. INSULATION SUPPORT SHALL BE INTERRUPTED AT THE CROSSINGS WITH THE STEAM TRACING PIPE AND SHALL BE SUPPORTED AT BOTH SIDES OF THE GAP.
13. NAMEPLATE SHALL BE PROPERLY SUPPORTED AT VESSEL TO ACCOMMODATE THE ROUTING OF THE STEAM TRACING PIPE.
14. STEAM TRACING PIPE SHALL BE BENT TO AVOID CLASHING WITH THE NOZZLES.
15. REINF. PAD OF PLATFORM CLIP AT 204° MAY BE CUT ACCORDINGLY TO PREVENT CLASHING WITH E2 SKIRT OPENING.

LEGEND

(XX) : NOZZLE MARKS
(XX) : MATERIAL LIST ITEMS
(W.) : WELD NUMBER
X : REVISION INDEX

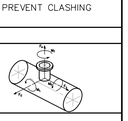

WELDING DETAILS

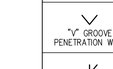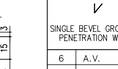BASIC SYMBOLS	SINGLE	DOUBLE	NOTES
FILLET WELD PLANE TYPE			UNLESS STATED OTHERWISE IN SHOP DETAILED DWGS, ALL FILLET WELDS MUST BE CONTINUOUS AND SHALL HAVE THICKNESS EQUAL TO 7/10 OF MINIMUM THICKNESS OF THE PLATES TO BE WELDED
			INTERMITTENT STAGGERED FILLET WELDS
"V" GROOVE PENETRATION WELD			SINGLE VEE GROOVE 6mm ≤ T ≤ 20mm DOUBLE VEE GROOVE ON BOTH SIDES SYMMETRICAL ABOUT REF. LINES T ≥ 20mm
SINGLE BEVEL GROOVE PENETRATION WELD			SINGLE BEVEL GROOVE 6mm ≤ T ≤ 20mm DOUBLE BEVEL GROOVE FINISH HALF CONVEX AND HALF FLUSH T ≥ 20mm

REV.	DRAWN	DATE	DESCRIPTION	CHECK.	APPR.	PMgnt.
6	A.V.	05.11.10	ISSUED FOR APPROVAL/CONSTRUCTION	E.V.	V.G.	G.V.
5	A.V.	18.06.10	ISSUED FOR APPROVAL/CONSTRUCTION	E.V.	V.G.	G.V.
4	A.V.	11.05.10	ISSUED FOR APPROVAL/CONSTRUCTION	E.V.	V.G.	G.V.
3	A.V.	06.11.09	ISSUED FOR APPROVAL/CONSTRUCTION	E.V.	V.G.	G.V.
2	S.K.	06.08.09	ISSUED FOR APPROVAL	E.V.	V.G.	G.V.
1	A.V.	28.05.09	ISSUED FOR APPROVAL	E.V.	V.G.	G.V.

PURCHASE ORDENER No.
EQUIPMENTS / TAGS No. 34–V–056

DATE :

VENDOR IDENTIFICATION : METRON S.A.

DOCUMENT TITLE : CONSTRUCTION DRAWING VESSEL: WASH WATER TANK

VENDOR DOCUMENT No. :	REV :	CODE :
7660–PZ–16 sheet 2 / 2	6	PLG–0003
TR DOCUMENT No. :	REV :	SCALE :
		1 : 10

This drawing and the copyright thereof is owned by Metron. Without our written permission this drawing may neither be copied nor submitted to third parties.